

# Work Order ID 67824

Thursday, March 31, 2011 12:48:06 PM



Page 1

Item ID: D2580-1

Accept



Setup Start



Revision ID:

Item Name: 205 Skidtube bent detail

Stop



Start Date: 3/31/2011 Start Qty: 2.00



Cust Item ID:

Required Date: 4/4/2011 Req'd Qty: 2.00



Customer:

Reference:

Approvals:

Process Plan:

*H*

Date: 11-03-87

Tooling:

Date:

QC:

Date:

SPC (Y/N):

Date:

Run Start



Stop



Sequence ID/  
Work Center ID

Operation  
Description

Set Up/  
Run Hours

Tool ID

Tool #

Plan  
Code

Accept  
Qty

Reject  
Qty

Reject  
Number

Insp.  
Stamp

Draw Nbr

Revision Nbr

D2580

RevD DEO-D1

100

0.00



Skidtubes

Memo

0.00

Skidtubes

1- Inspect mat'l D2500-1-190 for damage.

2-Drill pilot holes using drill jig DT 8149 (Do not use cutting fluid)

3-Open holes to 0.500" as per Dwg D2580 without cutting fluid

4-Deburr holes per QSI002 section 4.2.3 and blow out all chips from inside of tube

5- Chemical Conversion Coat as per QSI 005 4.1

6-Bond web in place per QSI 015.

□□

A/R Sikaflex-291 batch: 7M16445 □□□

Sikaflex expire date: 15 Jan 2012

Start time and date: 12h30 bond for 12hrs

SAD 11-04-18

SAD 11-04-19

11-4-18 (2)

| W/O: |      | WORK ORDER CHANGES |    |      |     |                                     |                          |
|------|------|--------------------|----|------|-----|-------------------------------------|--------------------------|
| DATE | STEP | PROCEDURE CHANGE   | By | Date | Qty | Approval<br>Chief Eng /<br>Prod Mgr | Approval<br>QC Inspector |
|      |      |                    |    |      |     |                                     |                          |
|      |      |                    |    |      |     |                                     |                          |

Part No: \_\_\_\_\_ PAR #: \_\_\_\_\_ Fault Category: \_\_\_\_\_ NCR: Yes No DQA: \_\_\_\_\_ Date: \_\_\_\_\_

Resolution: \_\_\_\_\_ Disposition: \_\_\_\_\_ QA: N/C Closed: \_\_\_\_\_ Date: \_\_\_\_\_

| NCR: |      | WORK ORDER NON-CONFORMANCE (NCR) |                             |                                 |                |                           |                       |                          |
|------|------|----------------------------------|-----------------------------|---------------------------------|----------------|---------------------------|-----------------------|--------------------------|
| DATE | STEP | Description of NC<br>Section A   | Corrective Action Section B |                                 |                | Verification<br>Section C | Approval<br>Chief Eng | Approval<br>QC Inspector |
|      |      |                                  | Initial<br>Chief Eng        | Action Description<br>Chief Eng | Sign &<br>Date |                           |                       |                          |
|      |      |                                  |                             |                                 |                |                           |                       |                          |
**NOTE:** Date & initial all entries

# Work Order ID 67824

Thursday, March 31, 2011 12:48:06 PM



Page 2

Item ID: D2580-1

Accept



Setup Start



Revision ID:

Stop



Item Name: 205 Skidtube bent detail

Start Date: 3/31/2011 Start Qty: 2.00



Cust Item ID:

Required Date: 4/4/2011 Req'd Qty: 2.00



Customer:

Reference:

Run Start



Approvals: Process Plan: \_\_\_\_\_ Date: \_\_\_\_\_ Tooling: \_\_\_\_\_ Date: \_\_\_\_\_

Stop



QC: \_\_\_\_\_ Date: \_\_\_\_\_ SPC (Y/N): \_\_\_\_\_ Date: \_\_\_\_\_

| Sequence ID/<br>Work Center ID | Operation<br>Description | Set Up/<br>Run Hours | Tool ID | Tool # | Plan<br>Code | Accept<br>Qty | Reject<br>Qty | Reject<br>Number | Insp.<br>Stamp |
|--------------------------------|--------------------------|----------------------|---------|--------|--------------|---------------|---------------|------------------|----------------|
|--------------------------------|--------------------------|----------------------|---------|--------|--------------|---------------|---------------|------------------|----------------|

101 QC6- Inspect dimensions to drawing

0.00



QC Memo

0.00

Quality Control

2 0 BEN/04/21

130 QC3- Inspect Part Finish

0.00



QC Memo

0.00

Quality Control

2 0 BEN/04/21

140 Identify as per dwg & Stock Location: *LC3*

0.00



Packaging Memo

0.00

Packaging

2 0 BEN/05/02

| W/O: |      | WORK ORDER CHANGES |    |      |     |                                     |                          |
|------|------|--------------------|----|------|-----|-------------------------------------|--------------------------|
| DATE | STEP | PROCEDURE CHANGE   | By | Date | Qty | Approval<br>Chief Eng /<br>Prod Mgr | Approval<br>QC Inspector |
|      |      |                    |    |      |     |                                     |                          |
|      |      |                    |    |      |     |                                     |                          |

Part No: \_\_\_\_\_ PAR #: \_\_\_\_\_ Fault Category: \_\_\_\_\_ NCR: Yes No DQA: \_\_\_\_\_ Date: \_\_\_\_\_

Resolution: \_\_\_\_\_ Disposition: \_\_\_\_\_ QA: N/C Closed: \_\_\_\_\_ Date: \_\_\_\_\_

| NCR: |      | WORK ORDER NON-CONFORMANCE (NCR) |                             |                                 |                |                           |                       |                          |
|------|------|----------------------------------|-----------------------------|---------------------------------|----------------|---------------------------|-----------------------|--------------------------|
| DATE | STEP | Description of NC<br>Section A   | Corrective Action Section B |                                 |                | Verification<br>Section C | Approval<br>Chief Eng | Approval<br>QC Inspector |
|      |      |                                  | Initial<br>Chief Eng        | Action Description<br>Chief Eng | Sign &<br>Date |                           |                       |                          |
|      |      |                                  |                             |                                 |                |                           |                       |                          |
**NOTE:** Date & initial all entries

Page 3

**Cust Item ID:**

**Customer:**



**Insp.  
Stamp**



0.00

11/5/37  
CL1105102

| W/O: |      | WORK ORDER CHANGES |    |      |     |                                     |                          |
|------|------|--------------------|----|------|-----|-------------------------------------|--------------------------|
| DATE | STEP | PROCEDURE CHANGE   | By | Date | Qty | Approval<br>Chief Eng /<br>Prod Mgr | Approval<br>QC Inspector |
|      |      |                    |    |      |     |                                     |                          |
|      |      |                    |    |      |     |                                     |                          |

Part No: \_\_\_\_\_ PAR #: \_\_\_\_\_ Fault Category: \_\_\_\_\_ NCR: Yes No DQA: \_\_\_\_\_ Date: \_\_\_\_\_

Resolution: \_\_\_\_\_ Disposition: \_\_\_\_\_ QA: N/C Closed: \_\_\_\_\_ Date: \_\_\_\_\_

| NCR: |      | WORK ORDER NON-CONFORMANCE (NCR) |                                |                                 |                |                           |                       |                          |
|------|------|----------------------------------|--------------------------------|---------------------------------|----------------|---------------------------|-----------------------|--------------------------|
| DATE | STEP | Description of NC<br>Section A   | Corrective Action<br>Section B |                                 |                | Verification<br>Section C | Approval<br>Chief Eng | Approval<br>QC Inspector |
|      |      |                                  | Initial<br>Chief Eng           | Action Description<br>Chief Eng | Sign &<br>Date |                           |                       |                          |
|      |      |                                  |                                |                                 |                |                           |                       |                          |
**NOTE:** Date & initial all entries

# Picklist Print

Thursday, March 31, 2011 12:48:14 PM

Page 1

Work Order ID: 67824



Parent Item: D2580-1

Parent Item Name: 205 Skidtube bent detail

Start Date: 3/31/2011

Required Date: 4/4/2011

Start Qty: 2.00

Required Qty: 2.00

Comments: IPP BL01.11.08 Revised Step 9, 10, 12, and 13 SM 10.12.01 as per DEO D1 DD ver:ec IPP Rev:C

| Component Item ID/<br>Item Name | Replacement<br>Item ID | Mfg/<br>Purch | Bin<br>Item | Primary<br>Location | Last<br>Location | Route<br>Seq ID | Unit of<br>Measure | Qty on<br>Hand | Qty per Kit | Total<br>Qty | Qty<br>Issued | Date<br>Issued | Status |
|---------------------------------|------------------------|---------------|-------------|---------------------|------------------|-----------------|--------------------|----------------|-------------|--------------|---------------|----------------|--------|
|---------------------------------|------------------------|---------------|-------------|---------------------|------------------|-----------------|--------------------|----------------|-------------|--------------|---------------|----------------|--------|

D2500-1-190

Manufactured

No

100

Each

35.0000

1

2



Ext'n - 'I' Beam Tube 4"

Location

Loc Qty

Loc Code

HALL

35

58427

35

D2596

Manufactured

No

100

Each

9.0000

1

2



Web, 205 Skidtube

Location

Loc Qty

Loc Code

LG

9

65508

1

67070

8

② 11-4-18  
SAD 11-4-19  
2

| W/O: |      | WORK ORDER CHANGES |    |      |     |                                     |                          |
|------|------|--------------------|----|------|-----|-------------------------------------|--------------------------|
| DATE | STEP | PROCEDURE CHANGE   | By | Date | Qty | Approval<br>Chief Eng /<br>Prod Mgr | Approval<br>QC Inspector |
|      |      |                    |    |      |     |                                     |                          |
|      |      |                    |    |      |     |                                     |                          |

Part No: \_\_\_\_\_ PAR #: \_\_\_\_\_ Fault Category: \_\_\_\_\_ NCR: Yes No DQA: \_\_\_\_\_ Date: \_\_\_\_\_

Resolution: \_\_\_\_\_ Disposition: \_\_\_\_\_ QA: N/C Closed: \_\_\_\_\_ Date: \_\_\_\_\_

| NCR: |      | WORK ORDER NON-CONFORMANCE (NCR) |                                |                                 |                |                           |                       |                          |
|------|------|----------------------------------|--------------------------------|---------------------------------|----------------|---------------------------|-----------------------|--------------------------|
| DATE | STEP | Description of NC<br>Section A   | Corrective Action<br>Section B |                                 |                | Verification<br>Section C | Approval<br>Chief Eng | Approval<br>QC Inspector |
|      |      |                                  | Initial<br>Chief Eng           | Action Description<br>Chief Eng | Sign &<br>Date |                           |                       |                          |
|      |      |                                  |                                |                                 |                |                           |                       |                          |
**NOTE:** Date & initial all entries



**DART****RELEASED**  
07.06.28 #**DEO ATTACHED**

|                            |                             |  |                        |
|----------------------------|-----------------------------|--|------------------------|
| DESIGN <i>[Signature]</i>  | DRAWN BY <i>[Signature]</i> | <b>DART AEROSPACE LTD</b><br>HAWKESBURY, ONTARIO, CANADA   |                        |
| CHECKED <i>[Signature]</i> | APPROVED <i>[Signature]</i> | DRAWING NO.<br>D2580                                       | REV. D<br>SHEET 1 OF 3 |
| DATE<br>07.02.27           |                             | TITLE<br>205 SKIDTUBE ASSEMBLY                             | SCALE<br>NTS           |
| A                          | 96.09.16                    | NEW ISSUE  |                        |
| B                          | 96.12.02                    | AS MANUFACTURED  |                        |
| C                          | 98.08.26                    | REDRAWN, INCLUDED DEO 9094/9097                            |                        |
| D                          | 07.02.27                    | CHANGE TO SS WEARPLATES AND GASKETS, INCLUDE DEO 9124/9183 |                        |

| QTY<br>-041 | QTY<br>-045 | Part Number   | Description       |
|-------------|-------------|---|-------------------|
| X           |             | D2580-041   | SKIDTUBE ASSEMBLY |
|             | X           | D2580-045   | SKIDTUBE ASSEMBLY |
| 1           | 1           | D2500-1-190   | EXTRUSION         |
| 1           | 1           | D2576-3   | STEP              |
| 20          | 24          | D2579   | CROSS BOLT SPACER |
| 16          | 16          | D2594-1   | PLUG              |
| 16          | 16          | D2594-3   | O-RING            |
| 1           | 1           | D2596   | 205 WEB           |
| 1           | 1           | D2855   | AFT CAP           |
| 1           | 1           | D3564-5   | WEARSHOE          |
| 1           | 1           | D3564-9   | WEARSHOE          |
| 1           | 1           | D3564-11  | WEARSHOE          |
| 1           | 1           | D3564-13  | WEARSHOE          |
| 2           | 2           | D3566-1   | GASKET            |
| 1           | 1           | D3566-5   | GASKET            |
| 1           | 1           | D3566-13  | GASKET            |
| 50          | 50          | ALS7-1032-130<br>or AKS7-1032-130<br>or AKS4-1032-130<br>or AELS-1032-130 | INSERT            |
| 50          | 50          | AN3C4A  | BOLT              |
| 2           | 2           | AN3-5A  | BOLT              |
| 50          | 50          | AN960C10L   | WASHER            |
| 2           | 2           | AN960JD10L  | WASHER            |

SHOP COPY

RETURN TO

ENGINEERING

UNCONTROLLED COPY

SUBJECT TO AMENDMENT

WITHOUT NOTICE

WORK ORDER

NO. *07824**PL11-03-31***GENERAL NOTES:**

- 1) TOLERANCES ARE PER DART QSI 018 UNLESS OTHERWISE NOTED
- 2) ALL DIMENSIONS ARE IN INCHES
- 3) INSERT D2596 WEB TO LOCATION SHOWN OFF AFT END OF SKIDTUBE AND BOND WEB INTO OUTER TUBE WITH NON-STRUCTURAL SIKAFLEX-241 ADHESIVE PER DART QSI 015 BEFORE BENDING. ENSURE HOLES LINE-UP.
- 4) BEND AS A SMOOTH RADIUS STARTING WITH A MAXIMUM CENTERLINE RADIUS OF 60 AND ENDING WITH A MINIMUM RADIUS OF 30. A MAXIMUM REDUCTION OF 0.200 IN DIAMETER IS ALLOWABLE IN THE BENT PORTION OF THE TUBE.
- 5) USE DART DRILL TEMPLATE TD2577-205 TO LOCATE AND DRILL Ø0.297 HOLES FOR WEARSHOE INSERTS. INSTALL ALS7-1032-130 PER SECTION D-D (50 PLACES) AFTER FINISH. INSTALL AN3C4A BOLTS AND AN960C10L WASHERS WITH SIKAFLEX-241/-291.
- 6) WELDING TO BE DONE PER DART QSI 004.
- 7) FINISH:  
SEE NOTES ON  
PAGE 2 FOR D2580-041 AND  
PAGE 3 FOR D2580-045
- 8) INSERT D2594-1 PLUG C/W D2594-3 O-RING IN HOLES MARKED 'P' (BOTH SIDES OF TUBE) AFTER FINISH (16 PLACES).

Copyright © 1996 by DART AEROSPACE LTD

THIS DOCUMENT IS PRIVATE AND CONFIDENTIAL AND IS SUPPLIED ON THE EXPRESS CONDITION THAT IT IS NOT TO BE USED FOR ANY PURPOSE OR COPIED OR COMMUNICATED TO ANY OTHER PERSON WITHOUT WRITTEN PERMISSION FROM DART AEROSPACE LTD.

| W/O: |      | WORK ORDER CHANGES |    |      |     |                                     |                          |
|------|------|--------------------|----|------|-----|-------------------------------------|--------------------------|
| DATE | STEP | PROCEDURE CHANGE   | By | Date | Qty | Approval<br>Chief Eng /<br>Prod Mgr | Approval<br>QC Inspector |
|      |      |                    |    |      |     |                                     |                          |
|      |      |                    |    |      |     |                                     |                          |

Part No: \_\_\_\_\_ PAR #: \_\_\_\_\_ Fault Category: \_\_\_\_\_ NCR: Yes No DQA: \_\_\_\_\_ Date: \_\_\_\_\_

Resolution: \_\_\_\_\_ Disposition: \_\_\_\_\_ QA: N/C Closed: \_\_\_\_\_ Date: \_\_\_\_\_

| NCR: |      | WORK ORDER NON-CONFORMANCE (NCR) |                             |                                 |                |                           |                       |                          |
|------|------|----------------------------------|-----------------------------|---------------------------------|----------------|---------------------------|-----------------------|--------------------------|
| DATE | STEP | Description of NC<br>Section A   | Corrective Action Section B |                                 |                | Verification<br>Section C | Approval<br>Chief Eng | Approval<br>QC Inspector |
|      |      |                                  | Initial<br>Chief Eng        | Action Description<br>Chief Eng | Sign &<br>Date |                           |                       |                          |
|      |      |                                  |                             |                                 |                |                           |                       |                          |
**NOTE:** Date & initial all entries

Diagram illustrating the grinding locations for the D2576-3 step. The diagram shows a cross-section of the step with the following labels:

- GRIND FLUSH (4 PLACES)
- GRIND FLUSH
- D2576-3 STEP
- LOCATION RIDGE ON UNDERSIDE OF D2576
- GRIND FLUSH

RELEASED  
07-06-28

**DEO ATTACHED**

Technical drawing of a circular component with the following annotations:

- DRILL PRIOR TO D2855 CAP INSTALLATION (2 PLACES)
- SEAL WITH SIKAFLEX-241/-291
- AN3-5A BOLT (1)
- AN980JDIOL WASHER (1)
- (2 PLACES)
- D2855 CAP
- 0.40

Diagram of a circular component with labels:

- D2579 SPACER
- D2596 WEB (REF)
- ALS7-1032-130 (REF)  
(TYP 50 PLACES)


Diagram showing the component after performance:

1. CHA
2. INS
3. WE
4. C'B

i) FINISH: ACID ETCH, ALODINE PER DART QSI 005 4.1 PRIOR TO INSERTING D2596 WEB POWDER COAT ASSEMBLY GLOSS WHITE (REF. 4.3.5.1) PER DART QSI 005 4.3 BLACK ANTI-SKID PAINT AS INDICATED PER DART QSI 005 4.4

37.50  
DISTANCE TO AFT END  
OF D2596 WEB  
3 7  
REFER TO DETAIL A  
1.750 1.750  
0.508 (TYP.)  
(40 PLACES)  
REFER TO DETAIL A  
8.750  
17.375  
26.000  
34.188  
57.313 (REF)  
7 EQUAL SPACES  
8.188 PITCH  
38.0  
91.500  
190.0  
(D2500-1)

[illegible]

|  |                       |          |   |             |              |
|--|-----------------------|----------|---|-------------|--------------|
| COPYRIGHT © 1998 BY DART AEROSPACE LTD.<br><br>THIS DOCUMENT IS PRIVATE AND CONFIDENTIAL<br>AND IS SUPPLIED ON THE EXPRESS CONDITION<br>THAT IT IS NOT TO BE USED FOR ANY PURPOSE<br>OR COPIED OR COMMUNICATED TO ANY OTHER<br>PERSON WITHOUT WRITTEN PERMISSION FROM<br>DART AEROSPACE LTD. | DESIGN                | DRAWN BY |  DART AEROSPACE LTD.<br>MARKHAM, ONTARIO, CANADA |             |              |
|  | CHECKED               | APPROVED |   | DRAWING NO. | REV. D       |
|  |                       |          |   | D2580       | SHEET 2 OF 3 |
|  | DATE                  | TITLE    |   |             | SCALE        |
| 07.02.27   | 205 SKIDTUBE ASSEMBLY |          |   | 1:24        |              |

| W/O: |      | WORK ORDER CHANGES |    |      |     |                                     |                          |
|------|------|--------------------|----|------|-----|-------------------------------------|--------------------------|
| DATE | STEP | PROCEDURE CHANGE   | By | Date | Qty | Approval<br>Chief Eng /<br>Prod Mgr | Approval<br>QC Inspector |
|      |      |                    |    |      |     |                                     |                          |
|      |      |                    |    |      |     |                                     |                          |


Part No: \_\_\_\_\_ PAR #: \_\_\_\_\_ Fault Category: \_\_\_\_\_ NCR: Yes No DQA: \_\_\_\_\_ Date: \_\_\_\_\_

Resolution: \_\_\_\_\_ Disposition: \_\_\_\_\_ QA: N/C Closed: \_\_\_\_\_ Date: \_\_\_\_\_

| NCR: |      | WORK ORDER NON-CONFORMANCE (NCR) |                                |                                 |                |                           |                       |                          |
|------|------|----------------------------------|--------------------------------|---------------------------------|----------------|---------------------------|-----------------------|--------------------------|
| DATE | STEP | Description of NC<br>Section A   | Corrective Action<br>Section B |                                 |                | Verification<br>Section C | Approval<br>Chief Eng | Approval<br>QC Inspector |
|      |      |                                  | Initial<br>Chief Eng           | Action Description<br>Chief Eng | Sign &<br>Date |                           |                       |                          |
|      |      |                                  |                                |                                 |                |                           |                       |                          |
**NOTE:** Date & initial all entries

SCALE 5:24

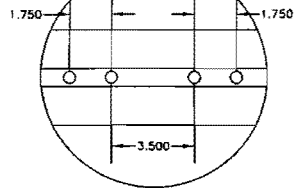


RELEASED  
07-16-28


**DETAIL F**  
SCALE 5:24

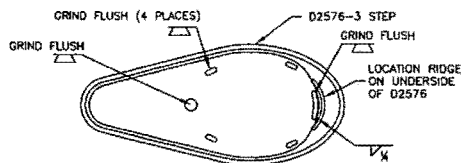


D2580-1 DRILLING DETAIL

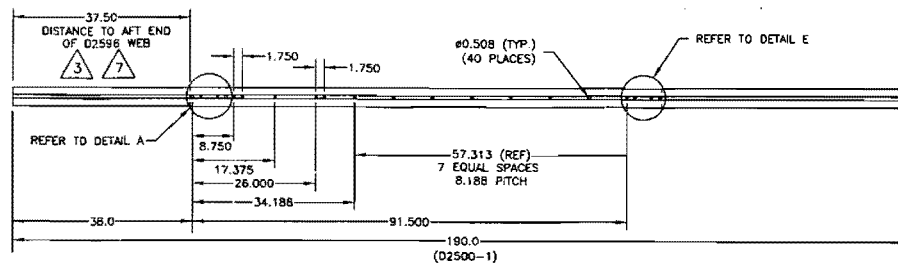


**D2580-5 BENDING AND CUTTING DETAIL**  
(MAKE FROM D2580-1 DRILLING DETAIL)

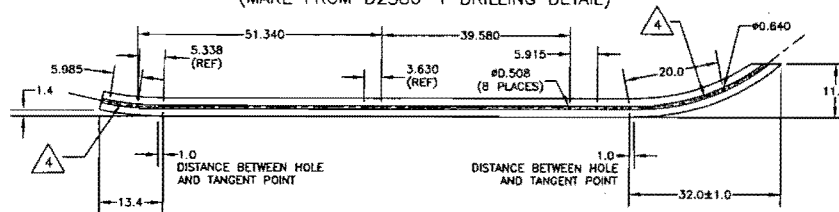

D2580-045 ASSEMBLY DETAIL

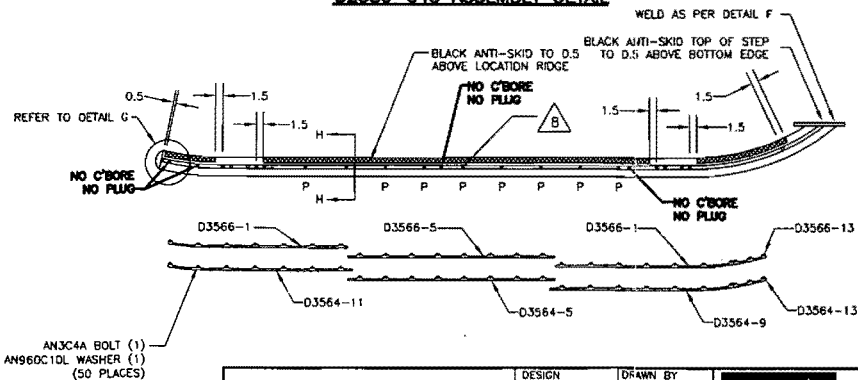

**SECTION H-H**  
SCALE 5:24

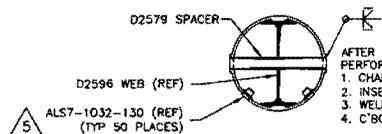

AFTER DRILLING AND BENDING ASSEMBLY  
PERFORM THE FOLLOWING FOR #0.508 HOLES ONLY:

1. CHAMFER HOLE 0.050 X 45°
2. INSERT D2579 SPACER (20 PLACES)
3. WELD INTO PLACE AND GRIND FLUSH
4. C'BORE D2579 SPACER TO #0.437 X 1.00 DEEP

**D2580-045 NOTES**

- i) FINISH: ACID ETCH, ALODINE PER DART QSI 005 4.1 PRIOR TO INSERTING D2596 WEB POWDER COAT ENTIRE ASSEMBLY GREEN (REF. 4.3.5.8) PER DART QSI 005 4.3 BLACK ANTI-SKID PAINT AS INDICATED PER DART QSI 005 4.4
- ii) IT IS ACCEPTABLE TO GRIND A RELIEF IN THE D2855 AFT CAP TO PREVENT INTERFERENCE WITH THE SPACER AT THIS LOCATION

**COPYRIGHT © 1998 BY DART AEROSPACE LTD.**

THIS DOCUMENT IS PRIVATE AND CONFIDENTIAL  
AND IS SUPPLIED ON THE EXPRESS CONDITION  
THAT IT IS NOT TO BE USED FOR ANY PURPOSE  
OR COPIED OR COMMUNICATED TO ANY OTHER  
PERSON WITHOUT WRITTEN PERMISSION FROM  
DART AEROSPACE LTD.

DESIGN

|          |  |
|----------|--|
| DRAWN BY |  |
|----------|--|

CHECKED

APPROVED

DATE \_\_\_\_\_

\_\_\_\_\_

**DART**

**DART AEROSPACE LTD.**  
HANOVER, ONTARIO, CANADA

|             |  |
|-------------|--|
| DRAWING NO. |  |
|-------------|--|

|                       |
|-----------------------|
| TITLE                 |
| 205 SKIDTUBE ASSEMBLY |

REV. D

SHEET 3 OF 3

SCALE

1.74

| W/O: |      | WORK ORDER CHANGES |    |      |     |                                     |                          |  |
|------|------|--------------------|----|------|-----|-------------------------------------|--------------------------|--|
| DATE | STEP | PROCEDURE CHANGE   | By | Date | Qty | Approval<br>Chief Eng /<br>Prod Mgr | Approval<br>QC Inspector |  |
|      |      |                    |    |      |     |                                     |                          |  |
|      |      |                    |    |      |     |                                     |                          |  |

Part No: \_\_\_\_\_ PAR #: \_\_\_\_\_ Fault Category: \_\_\_\_\_ NCR: Yes No DQA: \_\_\_\_\_ Date: \_\_\_\_\_

Resolution: \_\_\_\_\_ Disposition: \_\_\_\_\_ QA: N/C Closed: \_\_\_\_\_ Date: \_\_\_\_\_

| NCR: |      | WORK ORDER NON-CONFORMANCE (NCR) |                             |                                 |                |                           |                       |                          |
|------|------|----------------------------------|-----------------------------|---------------------------------|----------------|---------------------------|-----------------------|--------------------------|
| DATE | STEP | Description of NC<br>Section A   | Corrective Action Section B |                                 |                | Verification<br>Section C | Approval<br>Chief Eng | Approval<br>QC Inspector |
|      |      |                                  | Initial<br>Chief Eng        | Action Description<br>Chief Eng | Sign &<br>Date |                           |                       |                          |
|      |      |                                  |                             |                                 |                |                           |                       |                          |
**NOTE:** Date & initial all entries

|                      |                                |                        |   |  |                         |                           |              |
|----------------------|--------------------------------|------------------------|---|--|-------------------------|---------------------------|--------------|
| DRAWING NO.<br>D2580 | TITLE<br>205 SKIDTUBE ASSEMBLY | REV. D                 | DART AEROSPACE LTD<br>ENGINEERING ORDER |  | D.E.O. NO.<br>D2580-D-1 | SHEET NO.<br>SHEET 1 OF 1 | SCALE<br>NTS |
| DRAWN<br><i>UP</i>   | CHECKED<br><i>L</i>            | MFG. APPR.<br><i>E</i> | APPROVED<br><i>MP</i>                   |  | DE APPR.<br><i>H</i>    |                           |              |
| DATE<br>10.09.22     | DATE<br>10.11.04               | DATE<br>10.11.04       | DATE<br>10/11/04                        |  | DATE<br>10.11.04        |                           |              |

**PURPOSE:**

CHANGE ALL WELDED CROSSBOLT SPACERS TO SWAGED SPACERS

**CHANGE:**

PARTS LIST IS AMENDED AS FOLLOWS:


WAS

| QTY  | QTY  | PART NUMBER | DESCRIPTION       |
|------|------|-------------|-------------------|
| -041 | -045 |             |                   |
| 20   | 24   | D2579       | CROSS BOLT SPACER |

IS

|    |    |         |        |
|----|----|---------|--------|
| 20 | 24 | D4202-1 | SPACER |
|----|----|---------|--------|

SECTION D-D & SECTION H-H ARE AMENDED AS FOLLOWS:

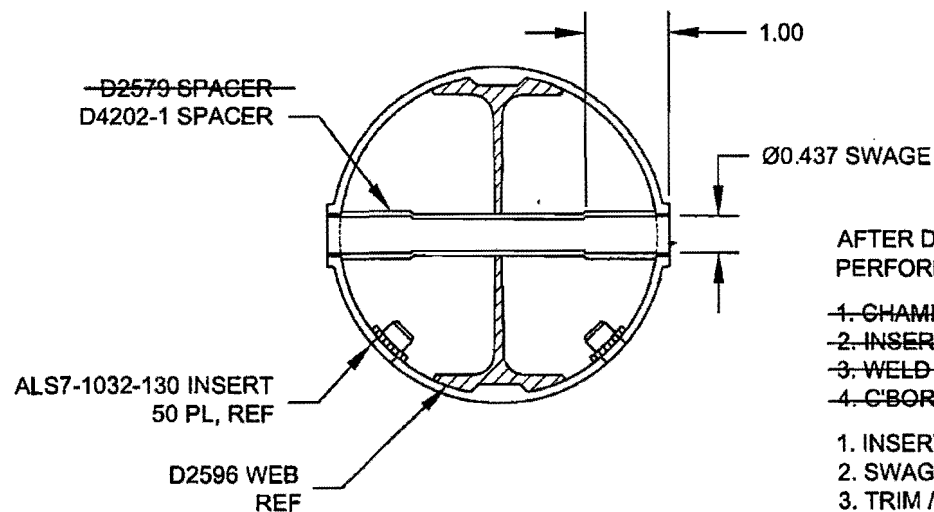

**SECTION D-D**  
NOT TO SCALE

**SECTION H-H**  
NOT TO SCALE

**RELEASED**  
2010-11-18  
*MP*

AFTER DRILLING AND BENDING ASSEMBLY  
PERFORM THE FOLLOWING FOR Ø0.508 HOLES ONLY:

- ~~1. CHAMFER HOLE 0.050 X 45°~~
- ~~2. INSERT D2579 SPACER (20 PLACES)~~
- ~~3. WELD INTO PLACE AND GRIND FLUSH~~
- ~~4. C-BORE D2579 SPACER TO Ø0.437 X 1.00 DEEP~~

1. INSERT D4202-1 SPACER, 20 PL (-041) OR 24 PL (-045)
2. SWAGE TO Ø0.437 X 1.00 DEEP PER QSI 002
3. TRIM / GRIND FLUSH PER QSI 002

| W/O: |      | WORK ORDER CHANGES |    |      |     |                                     |                          |
|------|------|--------------------|----|------|-----|-------------------------------------|--------------------------|
| DATE | STEP | PROCEDURE CHANGE   | By | Date | Qty | Approval<br>Chief Eng /<br>Prod Mgr | Approval<br>QC Inspector |
|      |      |                    |    |      |     |                                     |                          |
|      |      |                    |    |      |     |                                     |                          |

Part No: \_\_\_\_\_ PAR #: \_\_\_\_\_ Fault Category: \_\_\_\_\_ NCR: Yes No DQA: \_\_\_\_\_ Date: \_\_\_\_\_

Resolution: \_\_\_\_\_ Disposition: \_\_\_\_\_ QA: N/C Closed: \_\_\_\_\_ Date: \_\_\_\_\_

| NCR: |      | WORK ORDER NON-CONFORMANCE (NCR) |                                |                                 |                |                           |                       |                          |
|------|------|----------------------------------|--------------------------------|---------------------------------|----------------|---------------------------|-----------------------|--------------------------|
| DATE | STEP | Description of NC<br>Section A   | Corrective Action<br>Section B |                                 |                | Verification<br>Section C | Approval<br>Chief Eng | Approval<br>QC Inspector |
|      |      |                                  | Initial<br>Chief Eng           | Action Description<br>Chief Eng | Sign &<br>Date |                           |                       |                          |
|      |      |                                  |                                |                                 |                |                           |                       |                          |
**NOTE:** Date & initial all entries